

NO.	REVISION	DATE
1	PER TOWNSHIP COMMENTS	1/2/09
2	PER TOWNSHIP COMMENTS	1/16/09
3	PER SITE PLAN REVIEW	1/16/09



**JLW**  
**JOHN L. WALKER & ASSOCIATES**  
 755 YORK ROAD, SUITE 101 TEL: (215) 957-7690  
 WARMINSTER, PA. 18974 FAX: (215) 957-9590  
 ARCHITECTS ENGINEERS DESIGNERS

PROJECT TITLE  
**PROPOSED RENOVATIONS MIKADO RESTAURANT**  
 KT 70 EAST CHERRY HILL, NJ  
 CONTRACTOR AND SUBCONTRACTOR TO CHECK AND VERIFY ALL EXISTING CONDITIONS AND DIMENSIONS IN THE FIELD BEFORE WORK IS STARTED.

DRAWING TITLE  
**SITE PLAN**  
 DRAWN BY  
 SCALE 1" = 20'  
 DATE

SEAL

DRAWING NUMBER  
**SP**

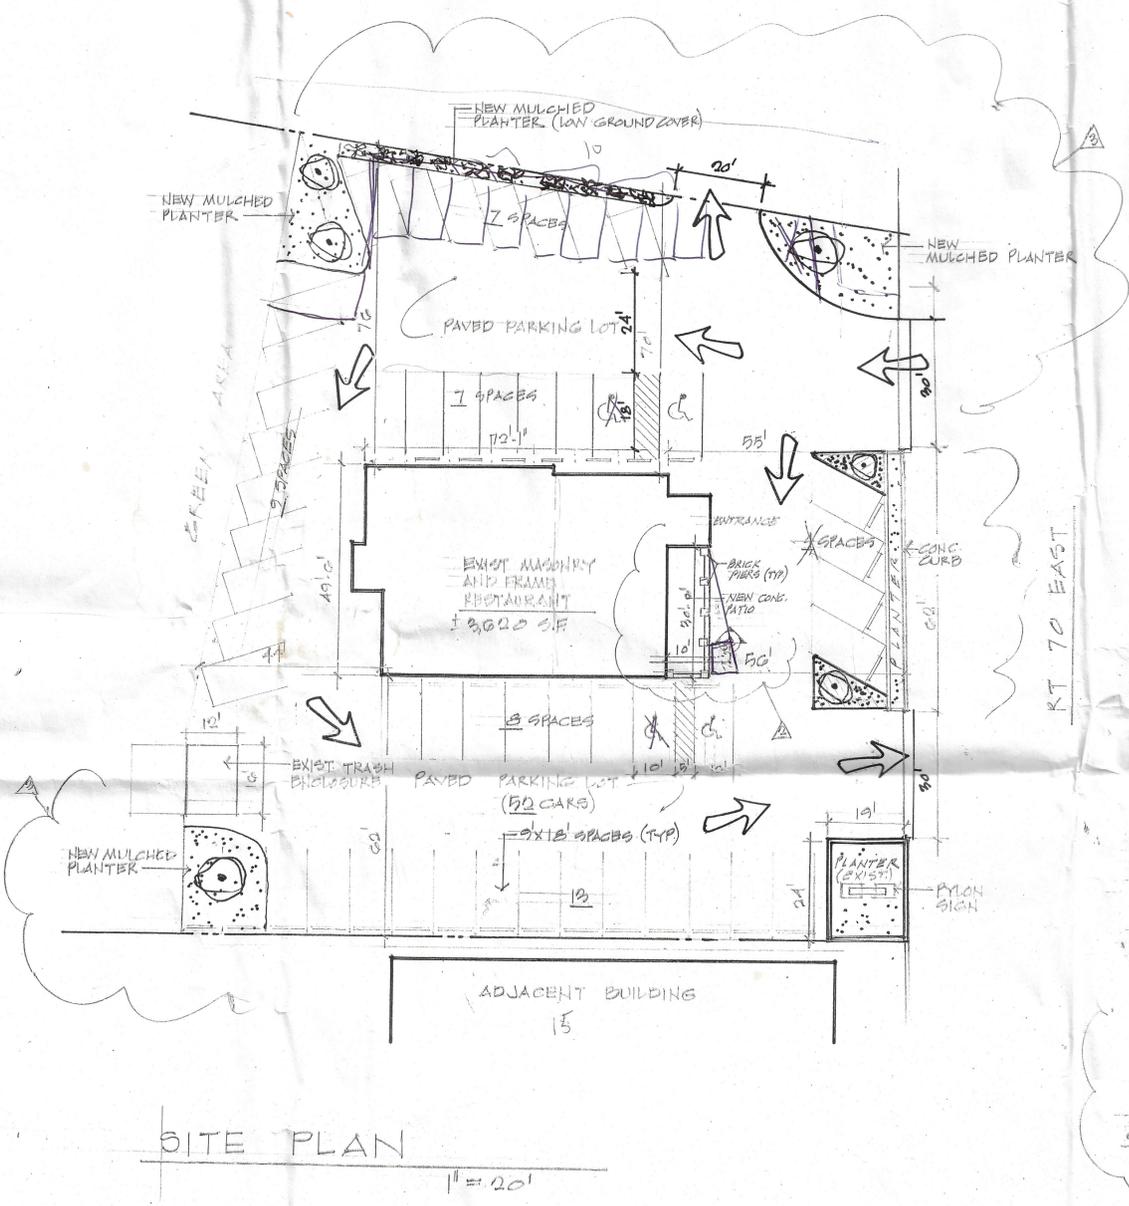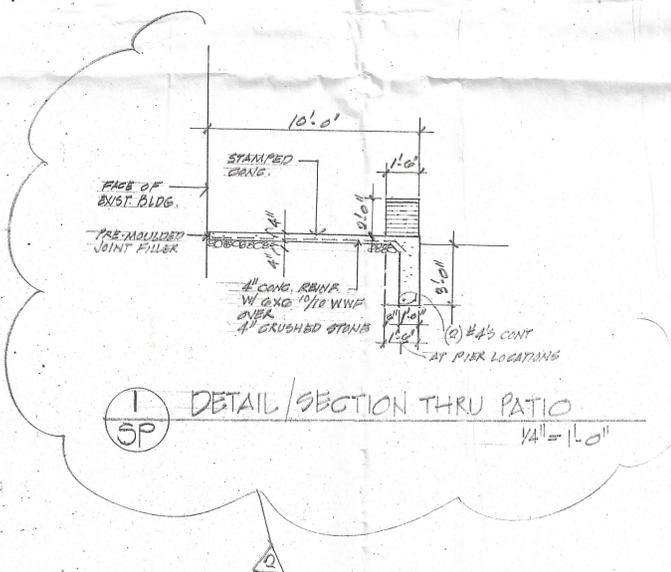

DINING AREA = 1495 S.F.  
 5 SPACES PER 1000 S.F. DINING = 7 SPACES REQUIRED  
 SPACES PROVIDED = 15

RESTAURANT: 3020 S.F.  
 KITCHEN: 1500 S.F. (10 EMPLOYEES)  
 GRATING: 106 SEATS  
 OCCUPANCY LOAD: 110

**MIKADO RESTAURANT**

**ARCHITECT:**  
 JOHN L. WALKER & ASSOCIATES  
 REGISTRATION NO. 11622  
 755 YORK ROAD  
 WARMINSTER, PA.  
 PHONE: (215) 957-7690

**CODE INFORMATION:**  
 INTERNATIONAL BUILDING CODE NJ ADDITION 2006  
 NATIONAL STANDARD PLUMBING CODE 2006  
 NATIONAL ELECTRIC CODE 2005  
 INTERNATIONAL MECHANICAL SUBCODE 2006  
 ACCESSIBILITY SUBCODE ICC/ANSI A117.1 2003  
 UNIFORM CONSTRUCTION CODE: 2006  
 USE GROUP: A-2 - RESTAURANT  
 CONSTRUCTION TYPE: 5B

64  
 215 694 6668